

Solvent Anodize Bench

Job - # L258

Description Of Operation



Process Vessel

This vessel includes a pump and filtered recirculation loop to produce a horizontal style flow path between the anode and cathode substrates. The recirculation pump is located in the lower storage compartment of the bench and is activated via a selector switch located on the front control panel. The pneumatically operated pump requires constant lubrication of the air motor. Please refer to the pump owners manual supplied for maintenance procedures and lubrication requirements. The filter housing is located at the rear of the process vessel and includes a manually operated vent valve.

This process vessel is manually filled with chemistry. The process vessel is drained to a waste container located in the lower storage compartment of the unit. The vessel should only be filled to the required level to wet the anode and cathode substrates. This will minimize the amount of waste container change outs during the drain process. The vessel is manually drained via a deadman style selector switch located on the front control panel.

The waste vessel is equipped with a custom fitted cap and also a vent cap. The vent cap should be removed during the drain process. Installed in the custom cap is a quick disconnect type fitting for the acid waste drain tube and a compression type fitting for a liquid level detection tube. The liquid level detection tube activates a pneumatically operated visual indicator located directly above the drain switch when the waste vessel is full. During the drain process the recirculation pump should be off and the filter housing purge valve should be opened. The pump can be bump started to minimize the amount of process liquid left in the system during the drain process.

Also included with the unit is (1) Nitrogen Spray Gun for operator convenience.

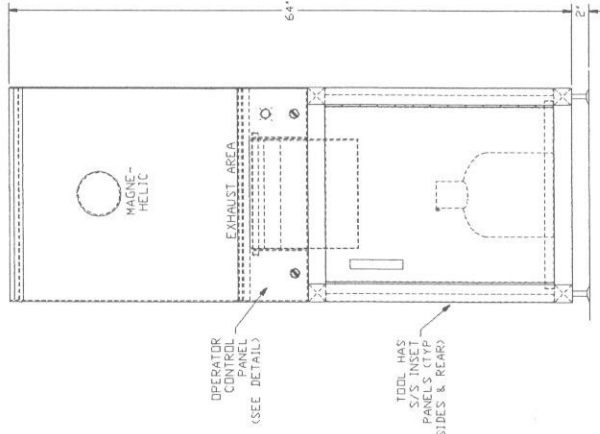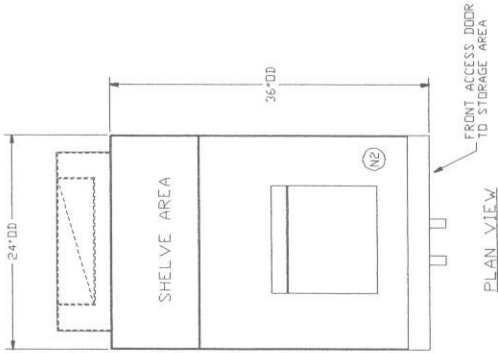


FRONT ELEVATION

NOTES:

1. MATERIAL OF CONSTRUCTION: STAINLESS STEEL
2. WASTE CONTAINMENT VESSEL IS LOCATED IN STORAGE AREA
3. PUMP IS LOCATED IN STORAGE AREA
4. TOOL HAS S/S ACCESS DOORS TO STORAGE AREA
5. TANK HAS RIM EXHAUST
6. TOOL HAS CASTERS AND LEVELING PADS AS REQUIRED



CONTROL PANEL DETAIL
(ENLARGED VIEW)

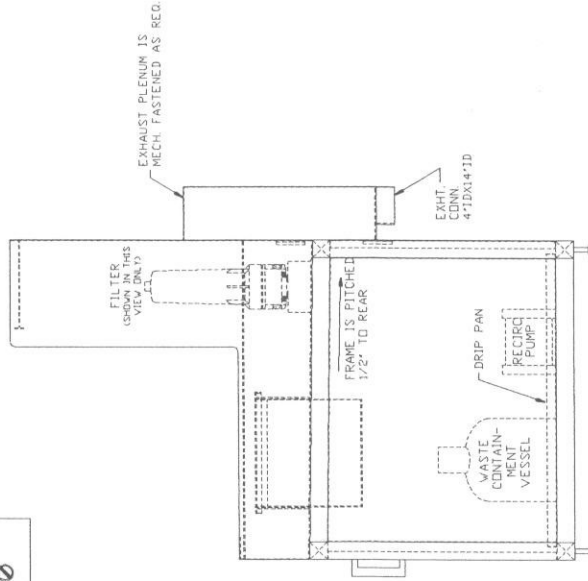

SIDE ELEVATION

REYNOLDSTECH

6895 KINNE STREET, EAST SYRACUSE, NEW YORK 13057 USA
(315)437-0532 (PHONE) (315)437-1390 (FAX)

This document is the property of ReynoldsTech Fabricators INC. and is loaned only upon condition that it is not to be copied or reproduced, nor to be used for furnishing information to others for any purpose detrimental to the interest of ReynoldsTech Fabricators INC.

LUCENT TECHNOLOGIES
SOVENT ANODIZE BENCH
TOOL CONSTRUCTION

| REV NO | DESCRIPTION | DR BY | DATE | SCALE | NONE | SHEET | DWG. NO. | REV |
|--------|-------------|-------|----------|-------|------|-------|----------|-----|
| 1 | AS BUILT | GVA | 02/17/00 | GVA | NONE | L258 | L258TL01 | 1 |

